




NOTES / REVISIONS
 NOTE: THIS DRAWING MUST NOT BE SCALED.
 ALL DIMENSIONS TO BE CHECKED ON SITE BY THE CONTRACTOR AND ANY DISCREPANCIES ARE TO BE REPORTED BACK TO THE ARCHITECTS A BEFORE WORK COMMENCES.

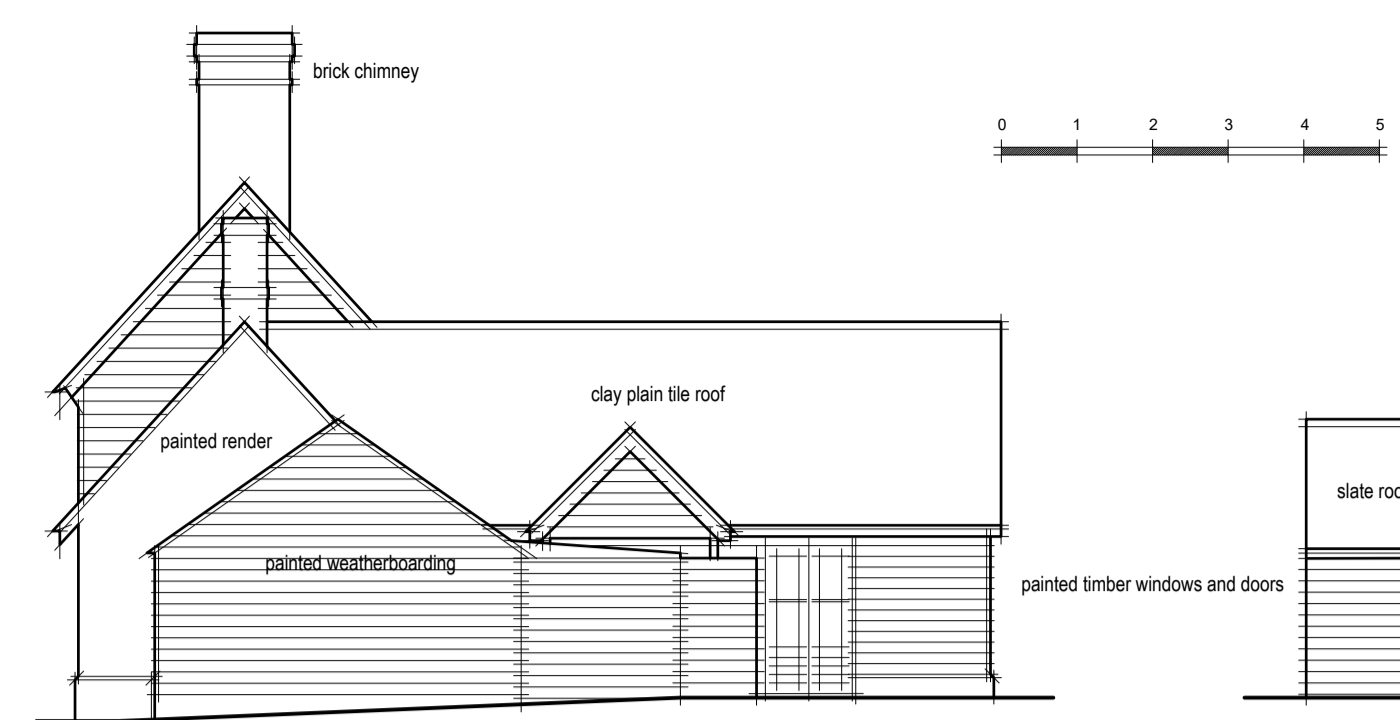


north elevation

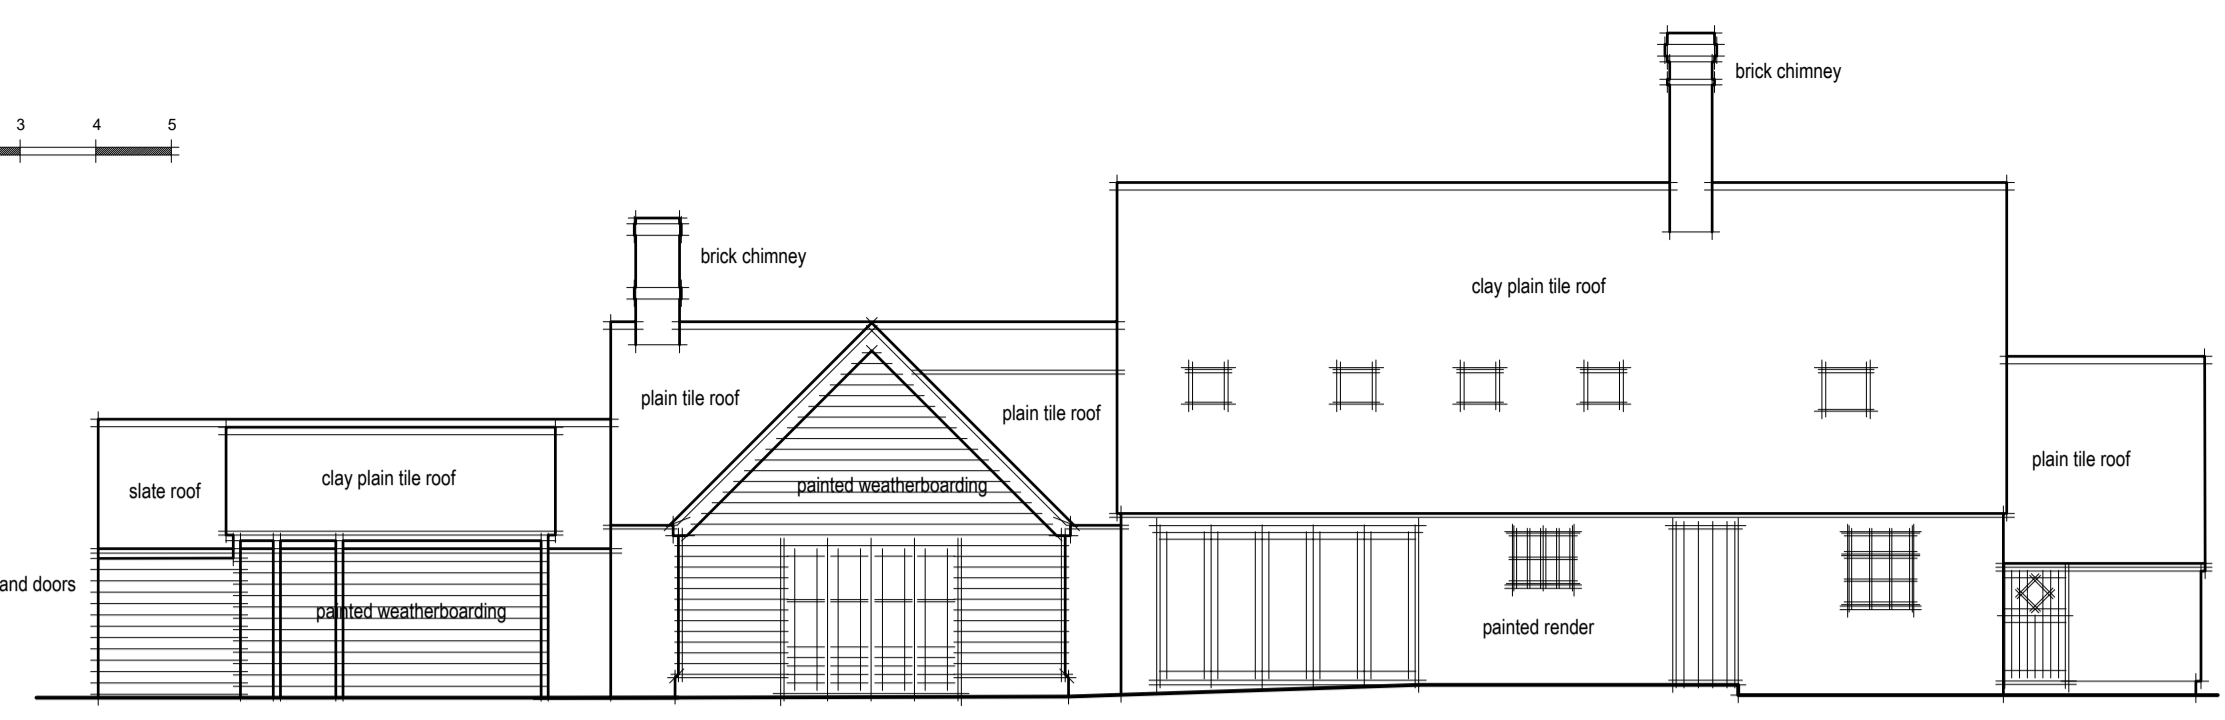


west elevation

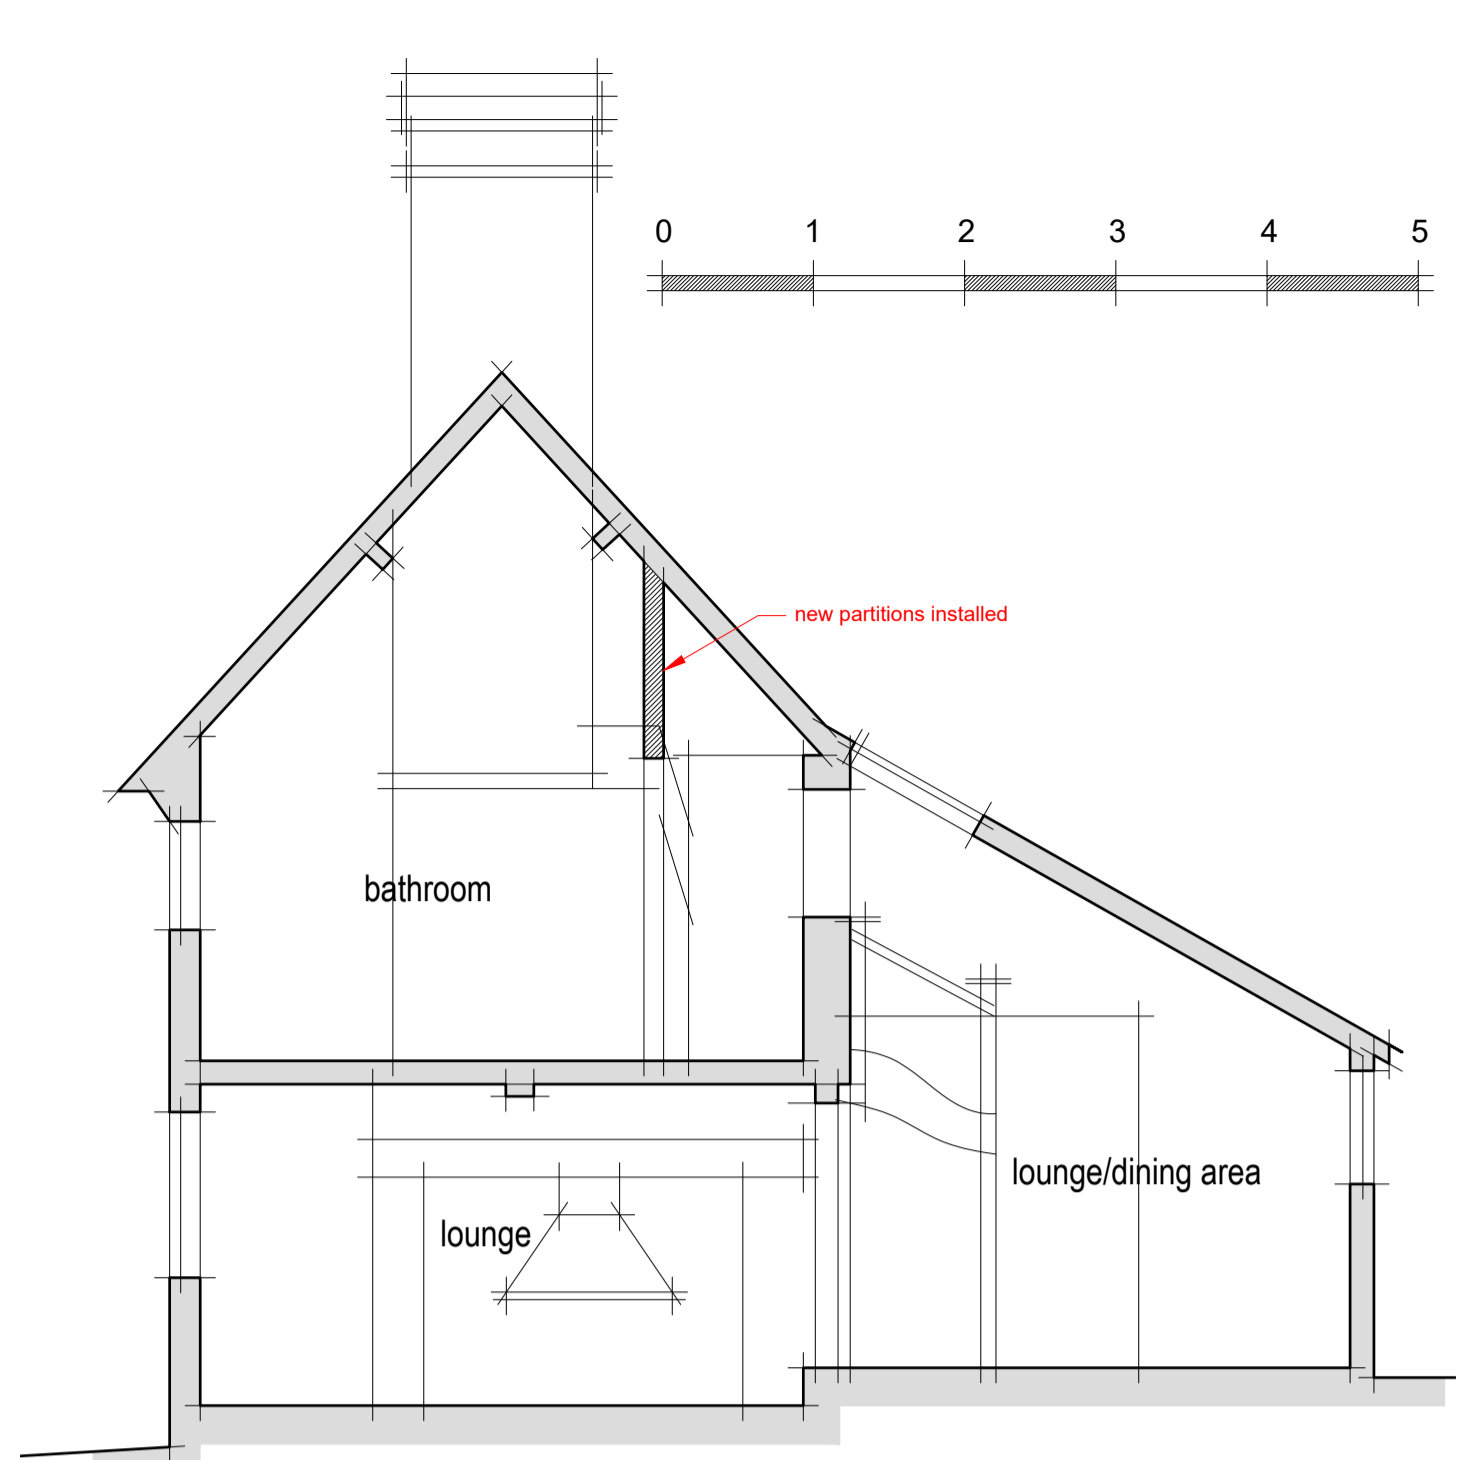


typical section

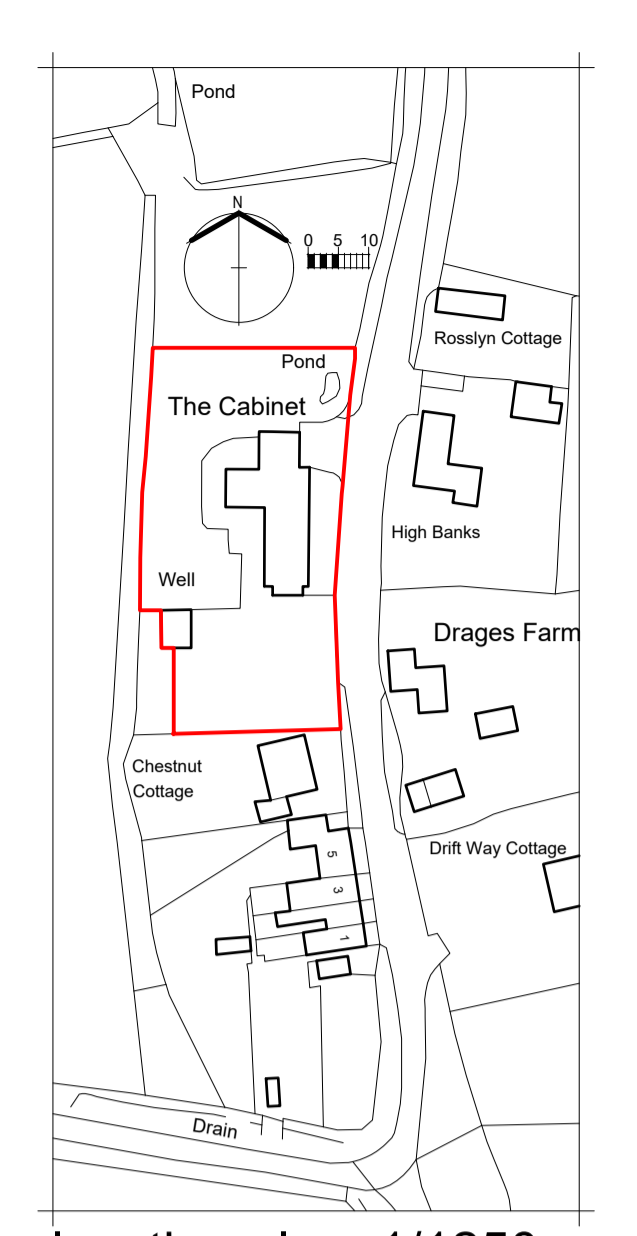


location plan 1/1250

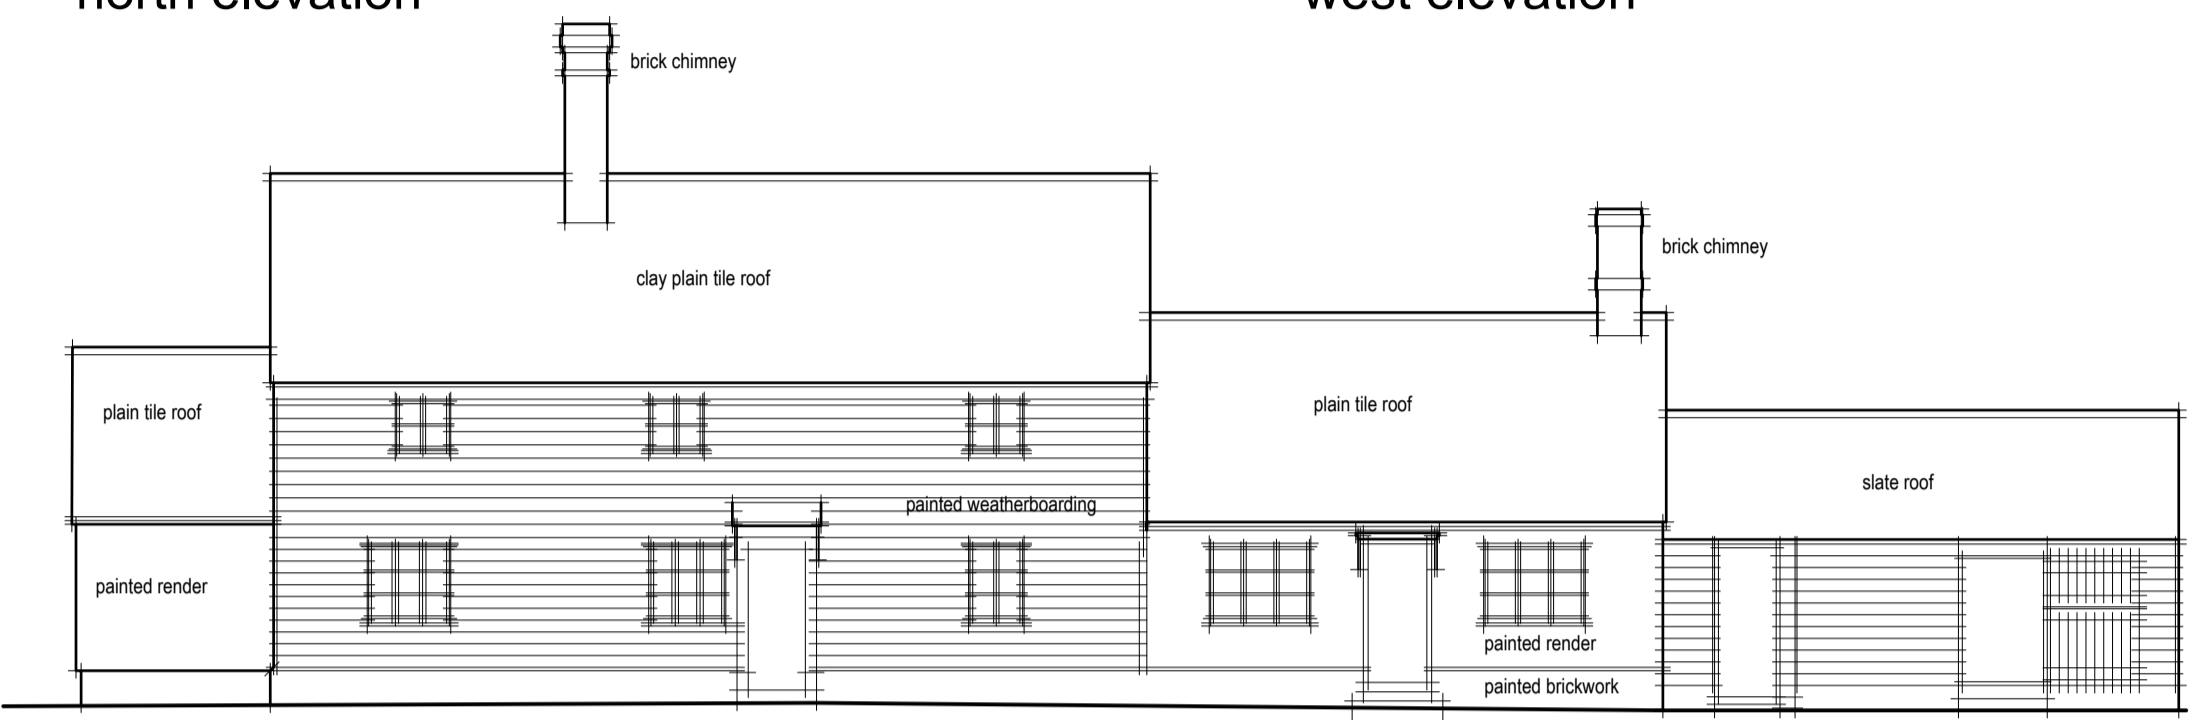


east elevation

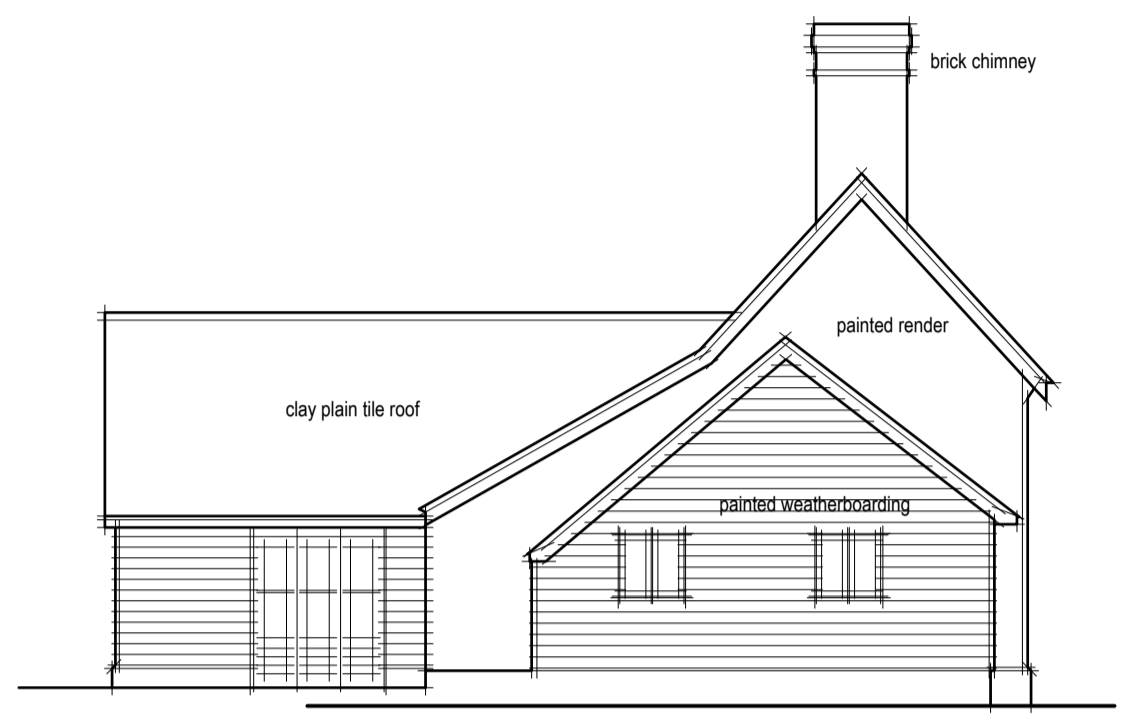

south elevation

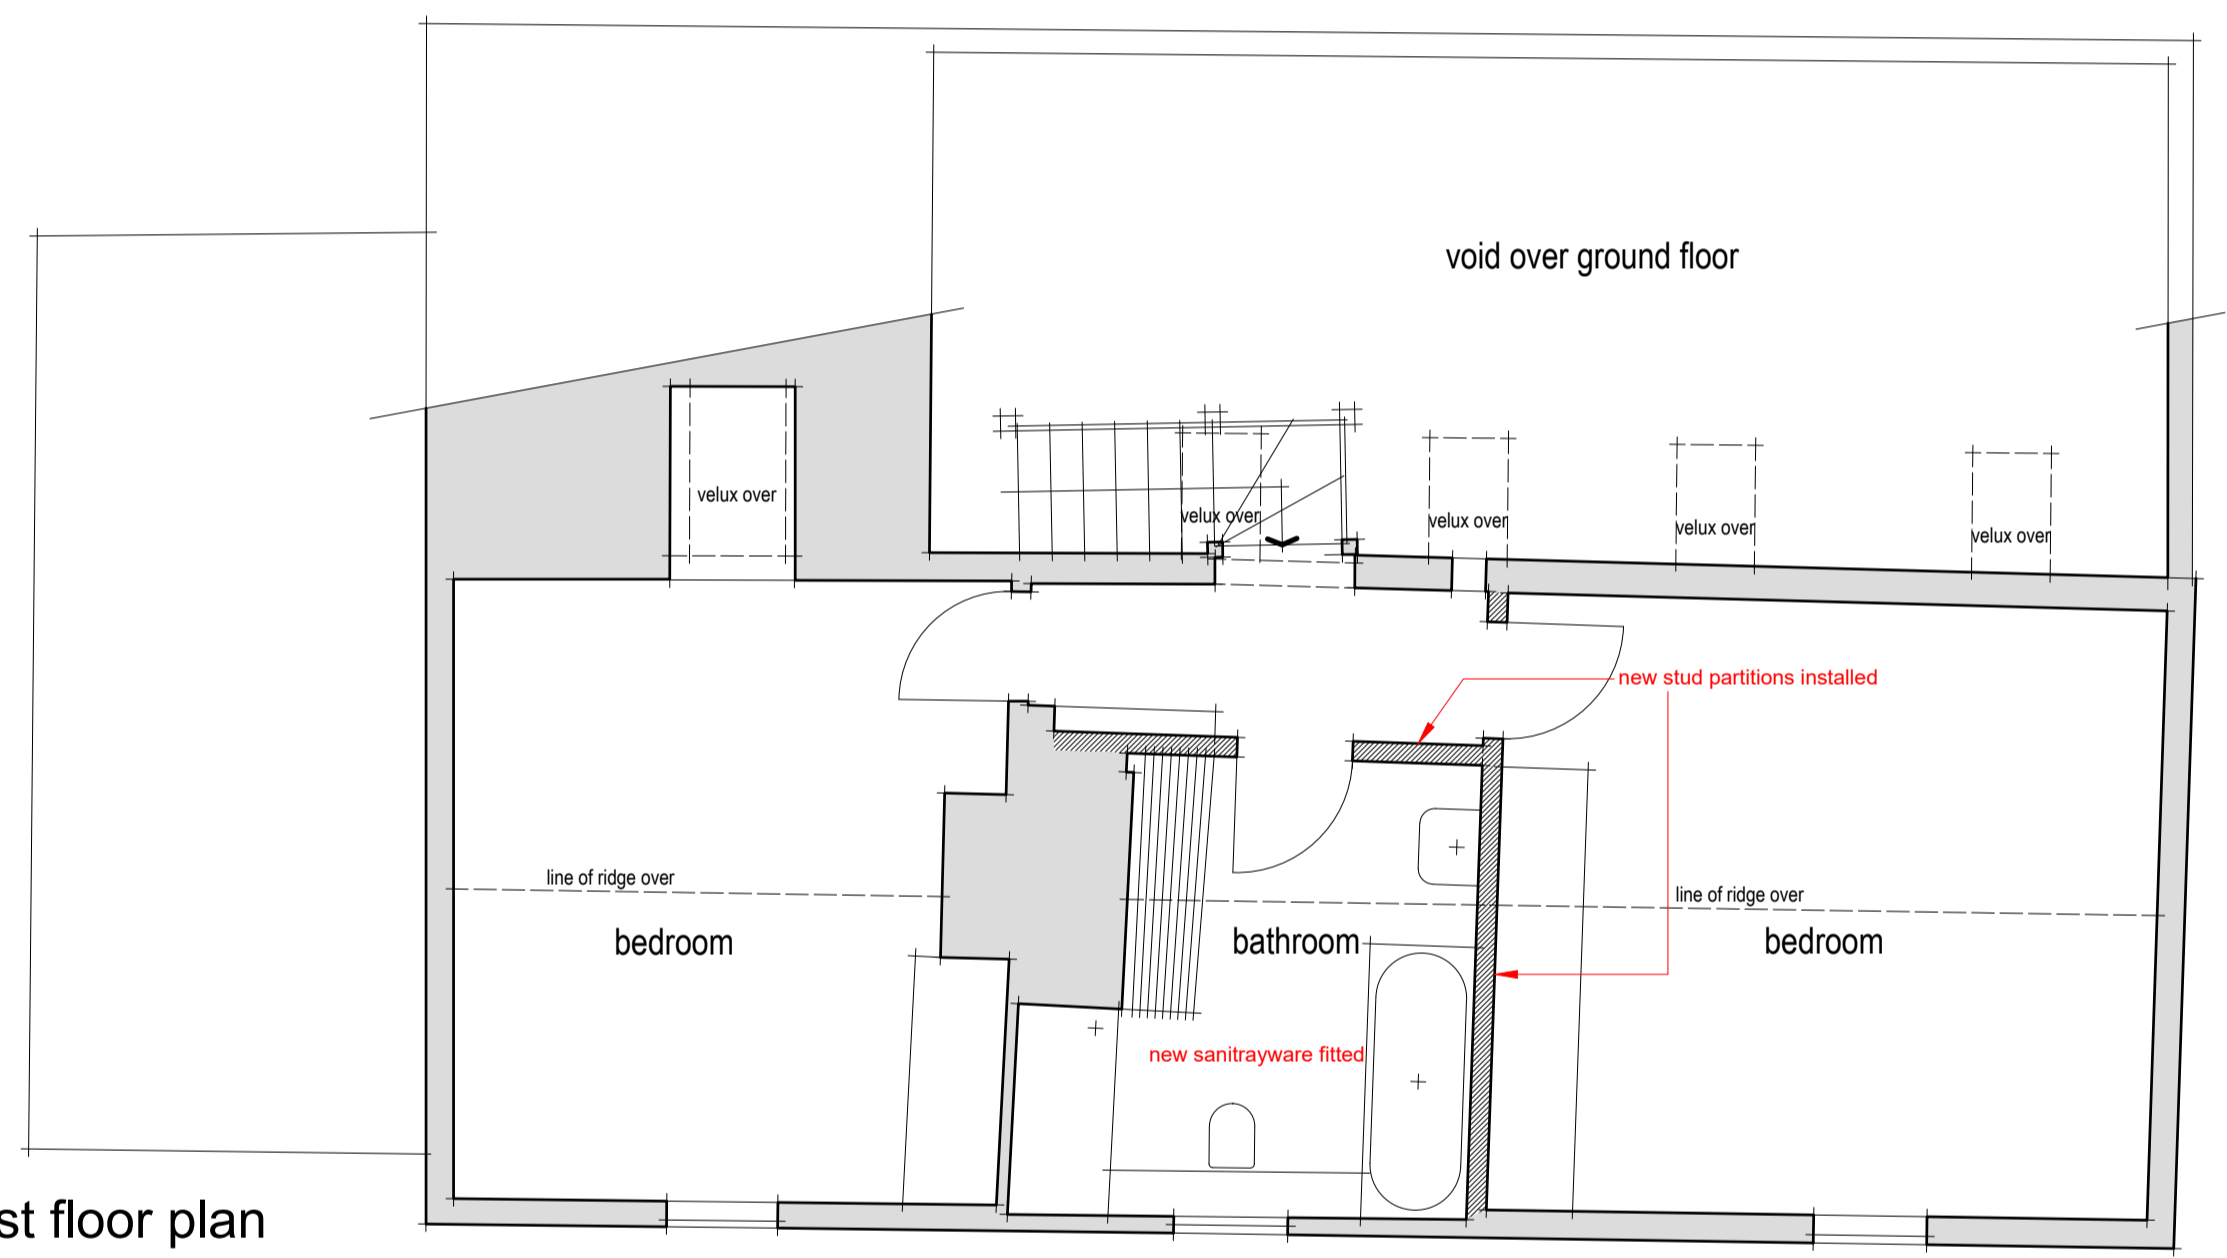


first floor plan

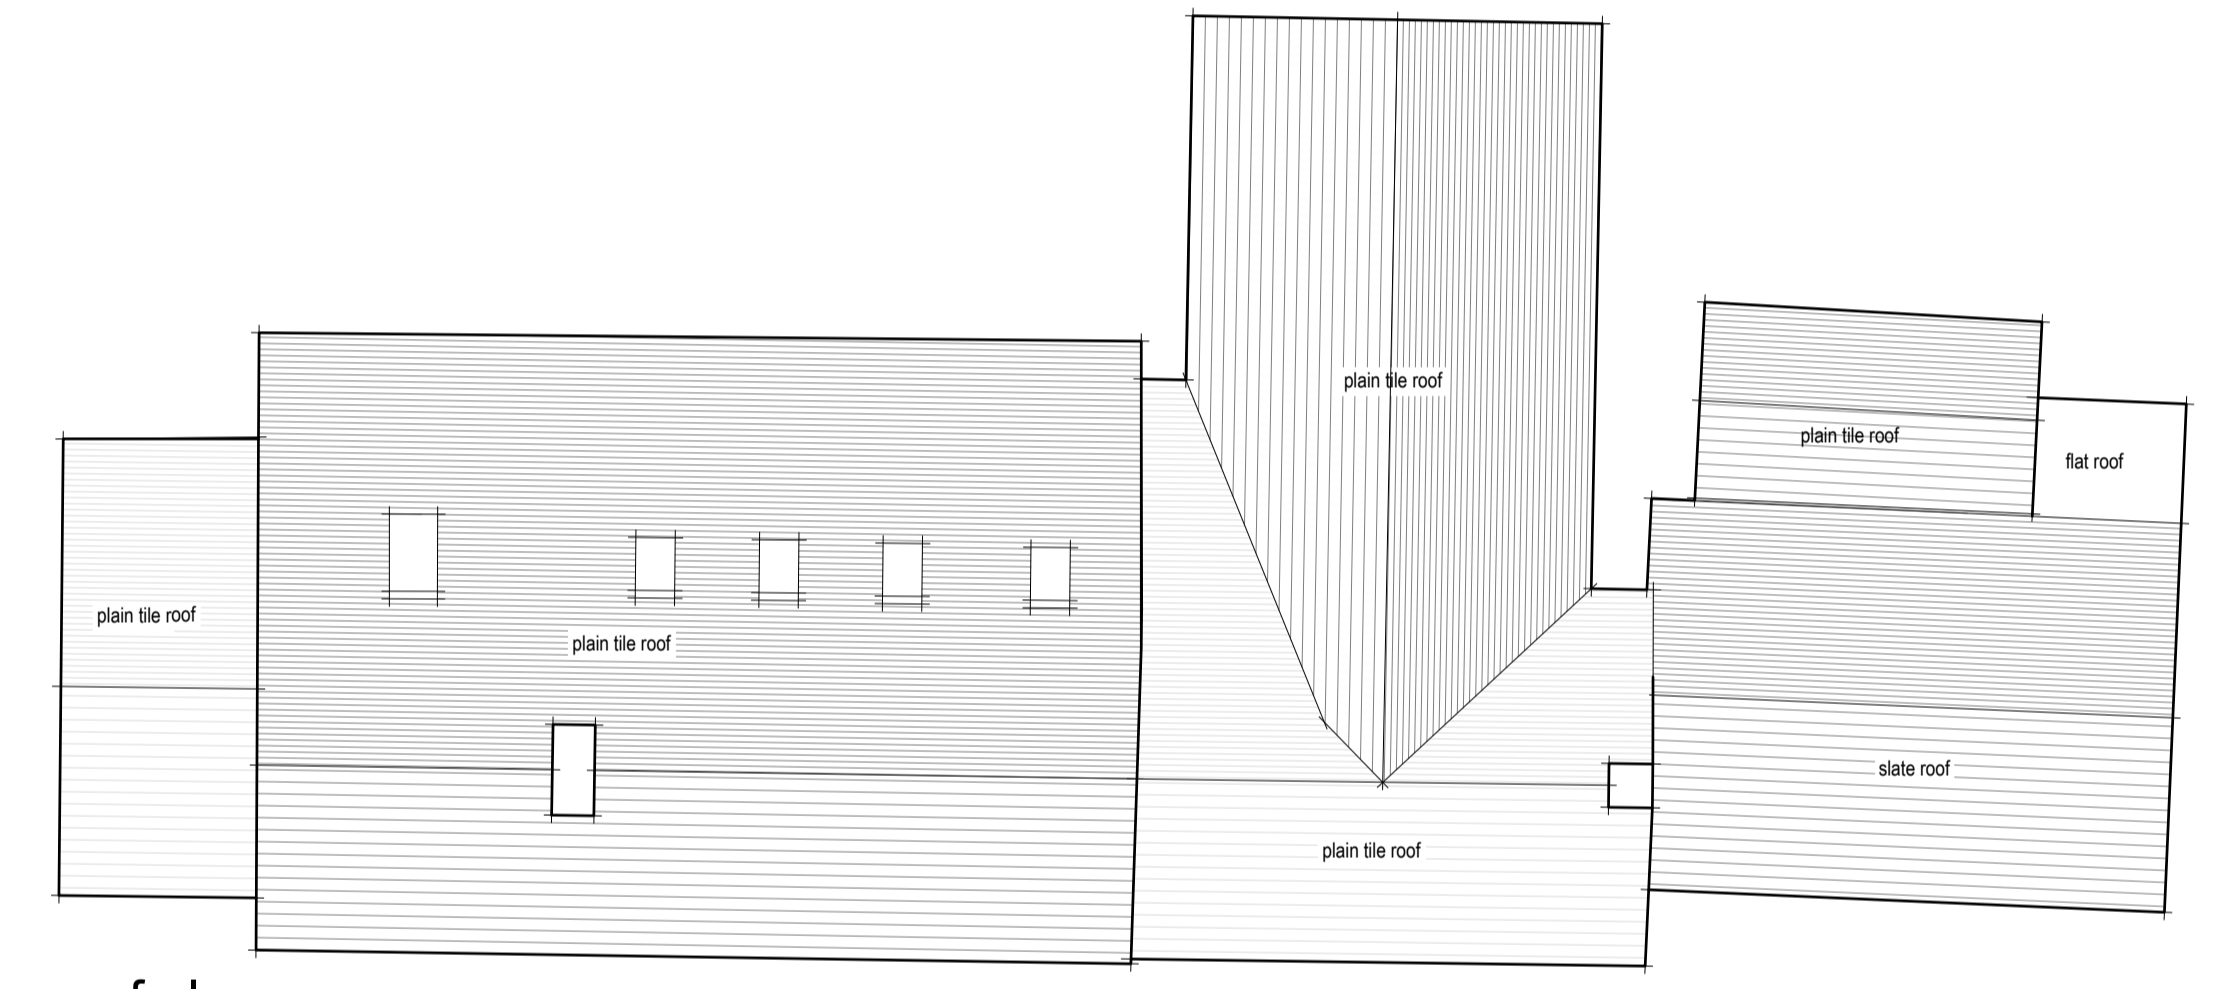

roof plan

PREMISES SHOWN AS SURVEYED ON 20 JULY 2016
 WORKS UNDERTAKEN BY CURRENT OWNER WITHOUT LISTED BUILDING CONSENT SHOWN IN RED

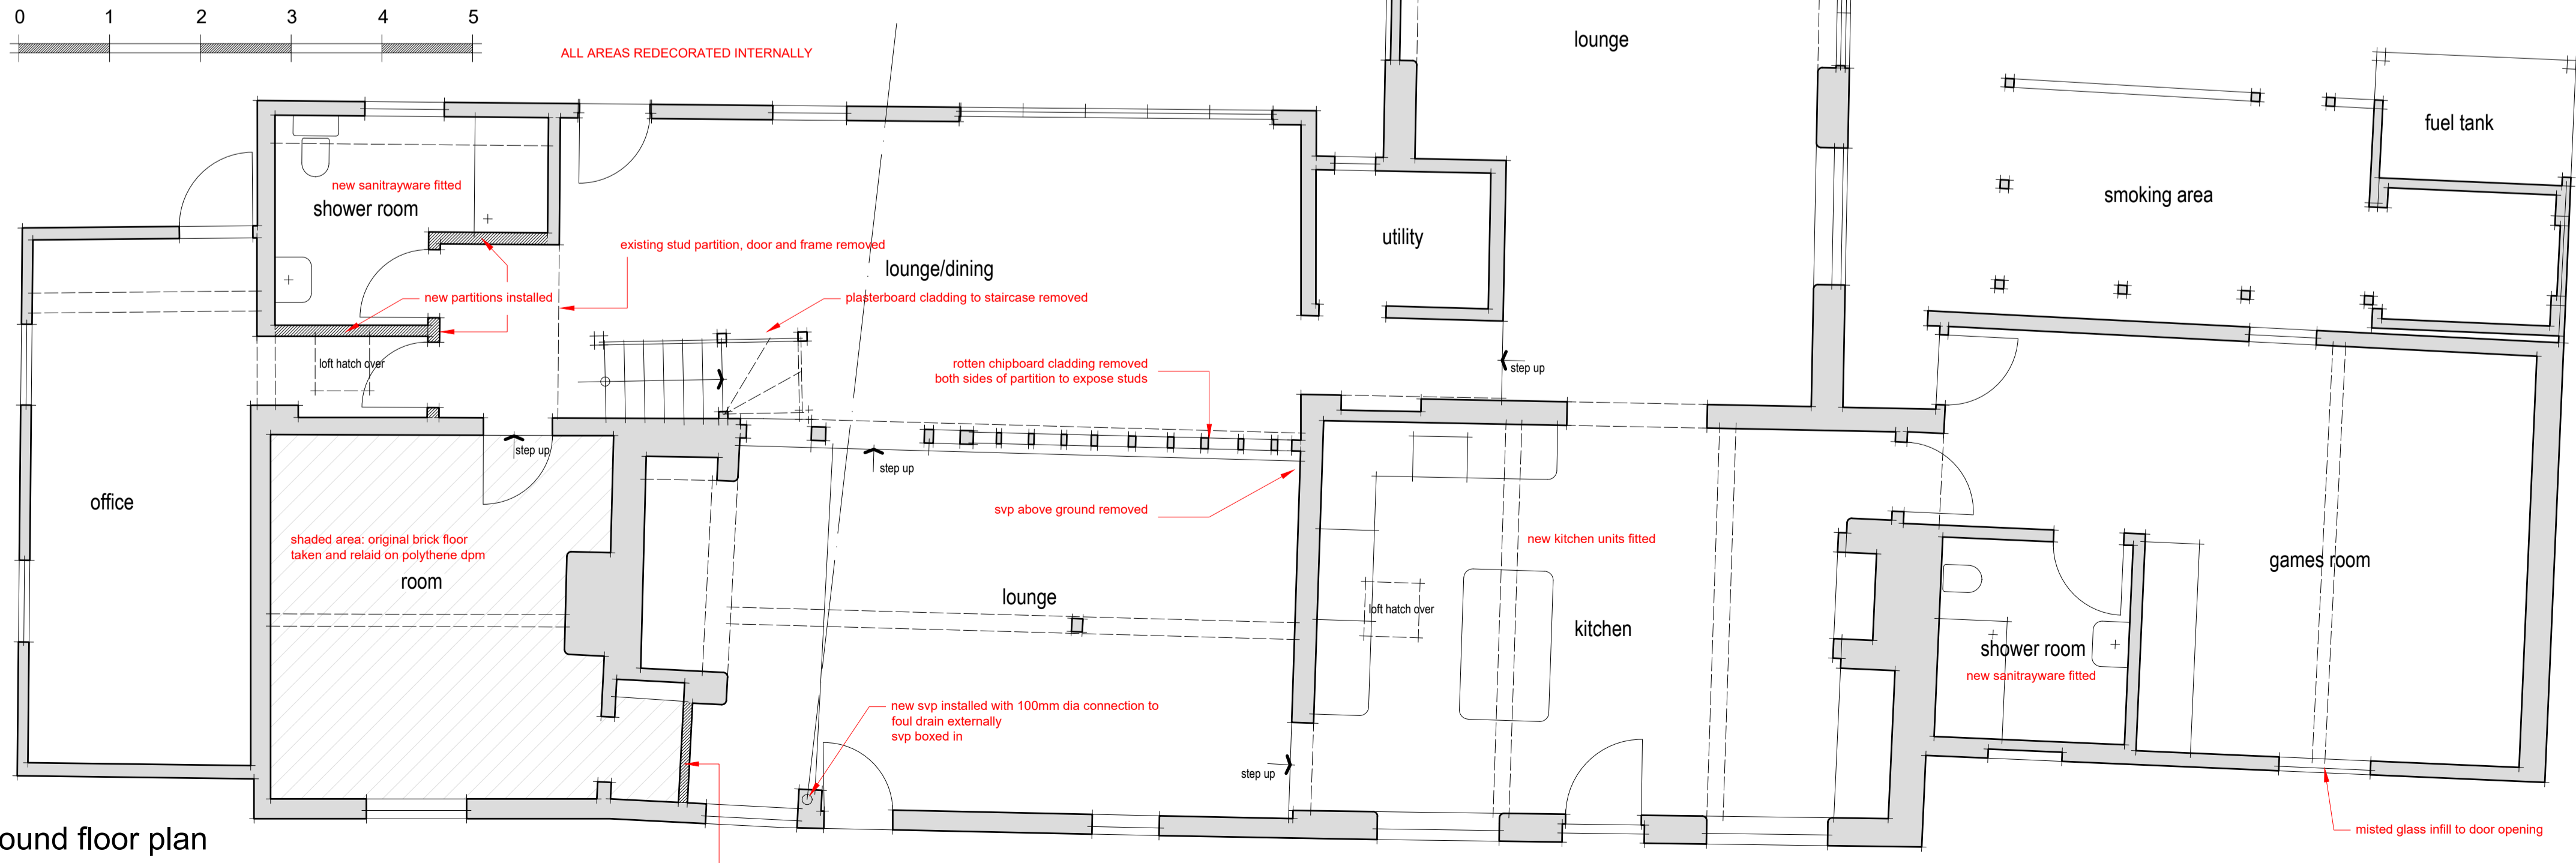

ground floor plan

revision a: roof lights added to western elevation - 1st september 2016 - mvc

PROJECT:	THE CABINET HIGH STREET REID HERTS SG8 8AH	
DRAWING:	EXISTING PLANS SECTION ELEVATIONS	
DATE:	AUG 2016	
SCALE:	1/50 1/100 at A1	
DRAWING NUMBER:	16/001/A/01 A	
DRAWN BY: MDC CHECKED:		<p>Parndon Mill Harlow Essex CM20 2HP</p> <p>T: 01279 444 904 E: info@sandts.co.uk W: www.sandts.co.uk</p>